



CONTRACTING

756 White Blossom Court
Powder Springs, GA 30127
Phone: (404) 630-1349

Proposed Change Order: 002

Project: Powder Springs Park - Phase 2

Proposed Change Order #002: Waterline Relocation - 8" DIP

Date: 1/7/2026

Change Reason: Client Requested

Schedule Impact: 7 days

Description:

This Proposed Change Order reflects the removal and relocation of the existing water main that was found to be in direct conflict with the proposed parking lot subgrade. Pricing includes all labor, equipment, and materials required to perform the relocation.

The proposed relocation is shown on the attached marked-up plan sheet and consists of approximately 170 linear feet of 8" DIP installed at a depth of 48" below the finished asphalt elevation. Pipe bedding will consist of 6" of #57 stone, and backfill will be completed with #57 stone.

Note:

The water main will remain inactive for the duration of this work.

Attached plan page shows approximate location.

Item No.	Item Description	Qty	UoM	Unit Price	Amount
	Replacement of Unsuitable	100	CY	\$ 192.00	\$ 19,200.00
	8" Water Main	170	LF	\$ 105.00	\$ 17,850.00
Total Change					\$ 37,050.00

Original Contract	\$ 1,008,871.00
Net Change by previously authorized Change Orders	\$ -
The contract sum prior to this Change Order	\$ 1,008,871.00
The contract sum will be increased by this Change Order in the amount of	\$ -
Contingency, Included in Contract	\$ 50,000.00
Contingency, Used to Date	\$ 3,278.35
Contingency, This Proposal	\$ 37,050.00
Contingency, Remaining	\$ 9,671.65
The new contract sum including this Change Order will be	\$ 1,008,871.00
The contract time will be increased by this Change Order by	7 days

See next page for signatures.

City of Powder Springs

SH Creel Contracting

Signed: _____


Signed: _____

By: _____

By: _____

Date: _____

Date: _____

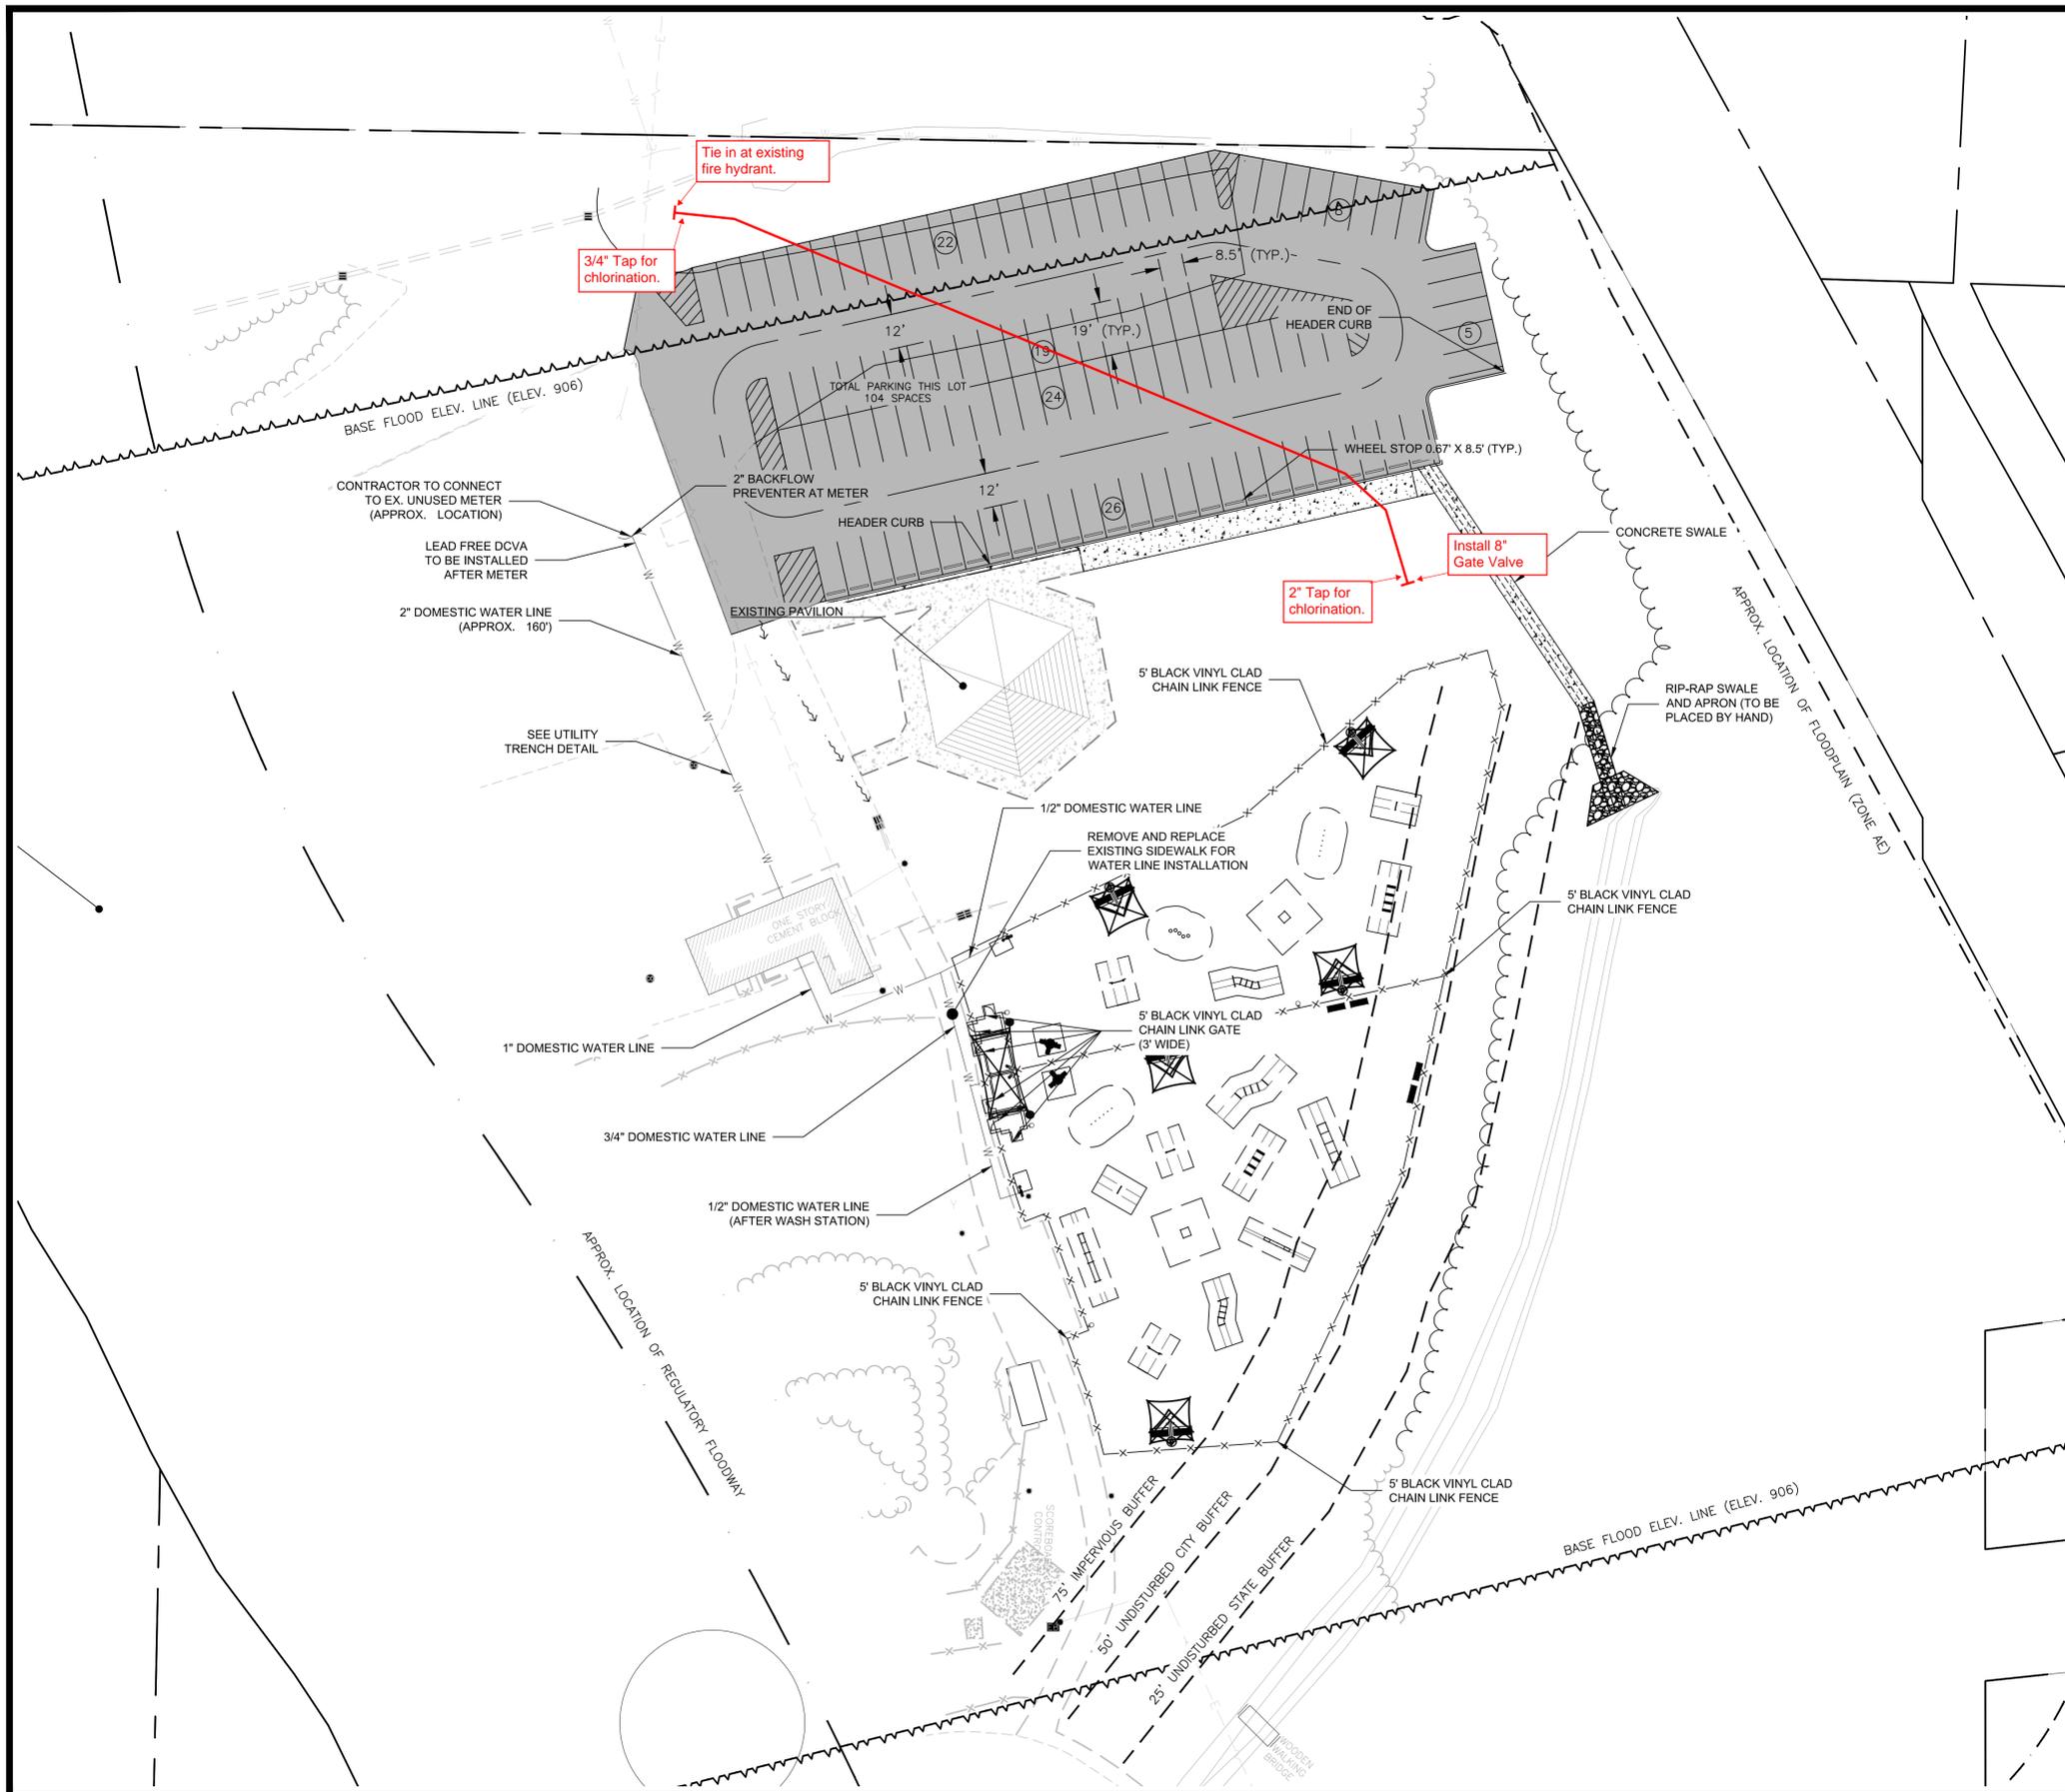

N

24 HOUR CONTACT:
DWAYNE EBERHART
TEL: 770-943-8010

SCALE IN FEET

CROY
200 NORTH COBB PARKWAY, BLDG. 400, SUITE 413
MARIETTA, GA 30062
PHONE: (770) 971-5407 FAX: (770) 971-0620
THESE PLANS AND DRAWINGS ARE NOT TO BE REPRODUCED, CHANGED OR COPIED IN ANY FORM OR MANNER WITHOUT THE WRITTEN PERMISSION AND CONSENT OF CROY ENGINEERING, L.L.C. ANY USE OF THESE PLANS WITHOUT WRITTEN PERMISSION IS PROHIBITED.

**POWDER SPRINGS PARK - DOG
PARK**
CONSTRUCTION DOCUMENTS
LAND LOT(S) 901
OF THE 19TH DISTRICT, ##### SECTION
CITY OF POWDER SPRINGS, COBB COUNTY, GEORGIA

NO.	REVISION REFERENCE	DATE

SEAL

GSWCC CERT #14353
SHEET TITLE
SITE & UTILITY PLAN

DRAWN BY ----	CHECKED BY KAK
SCALE 1"=30'	ISSUE DATE 08/29/2025

PROJECT NUMBER
2503.031
DRAWING NUMBER
C-200
SHEET 4 of 14

Drawing Location: C:\Users\lucy\OneDrive\Desktop\2503.031 Powder Springs Park Phase 2\Engineering\Drawings\2503.031 Plan.dwg Plot Scale: 1"=30' Drawing Plot Date: 08/29/2025 4:14 PM

ISSUED FOR CONSTRUCTION